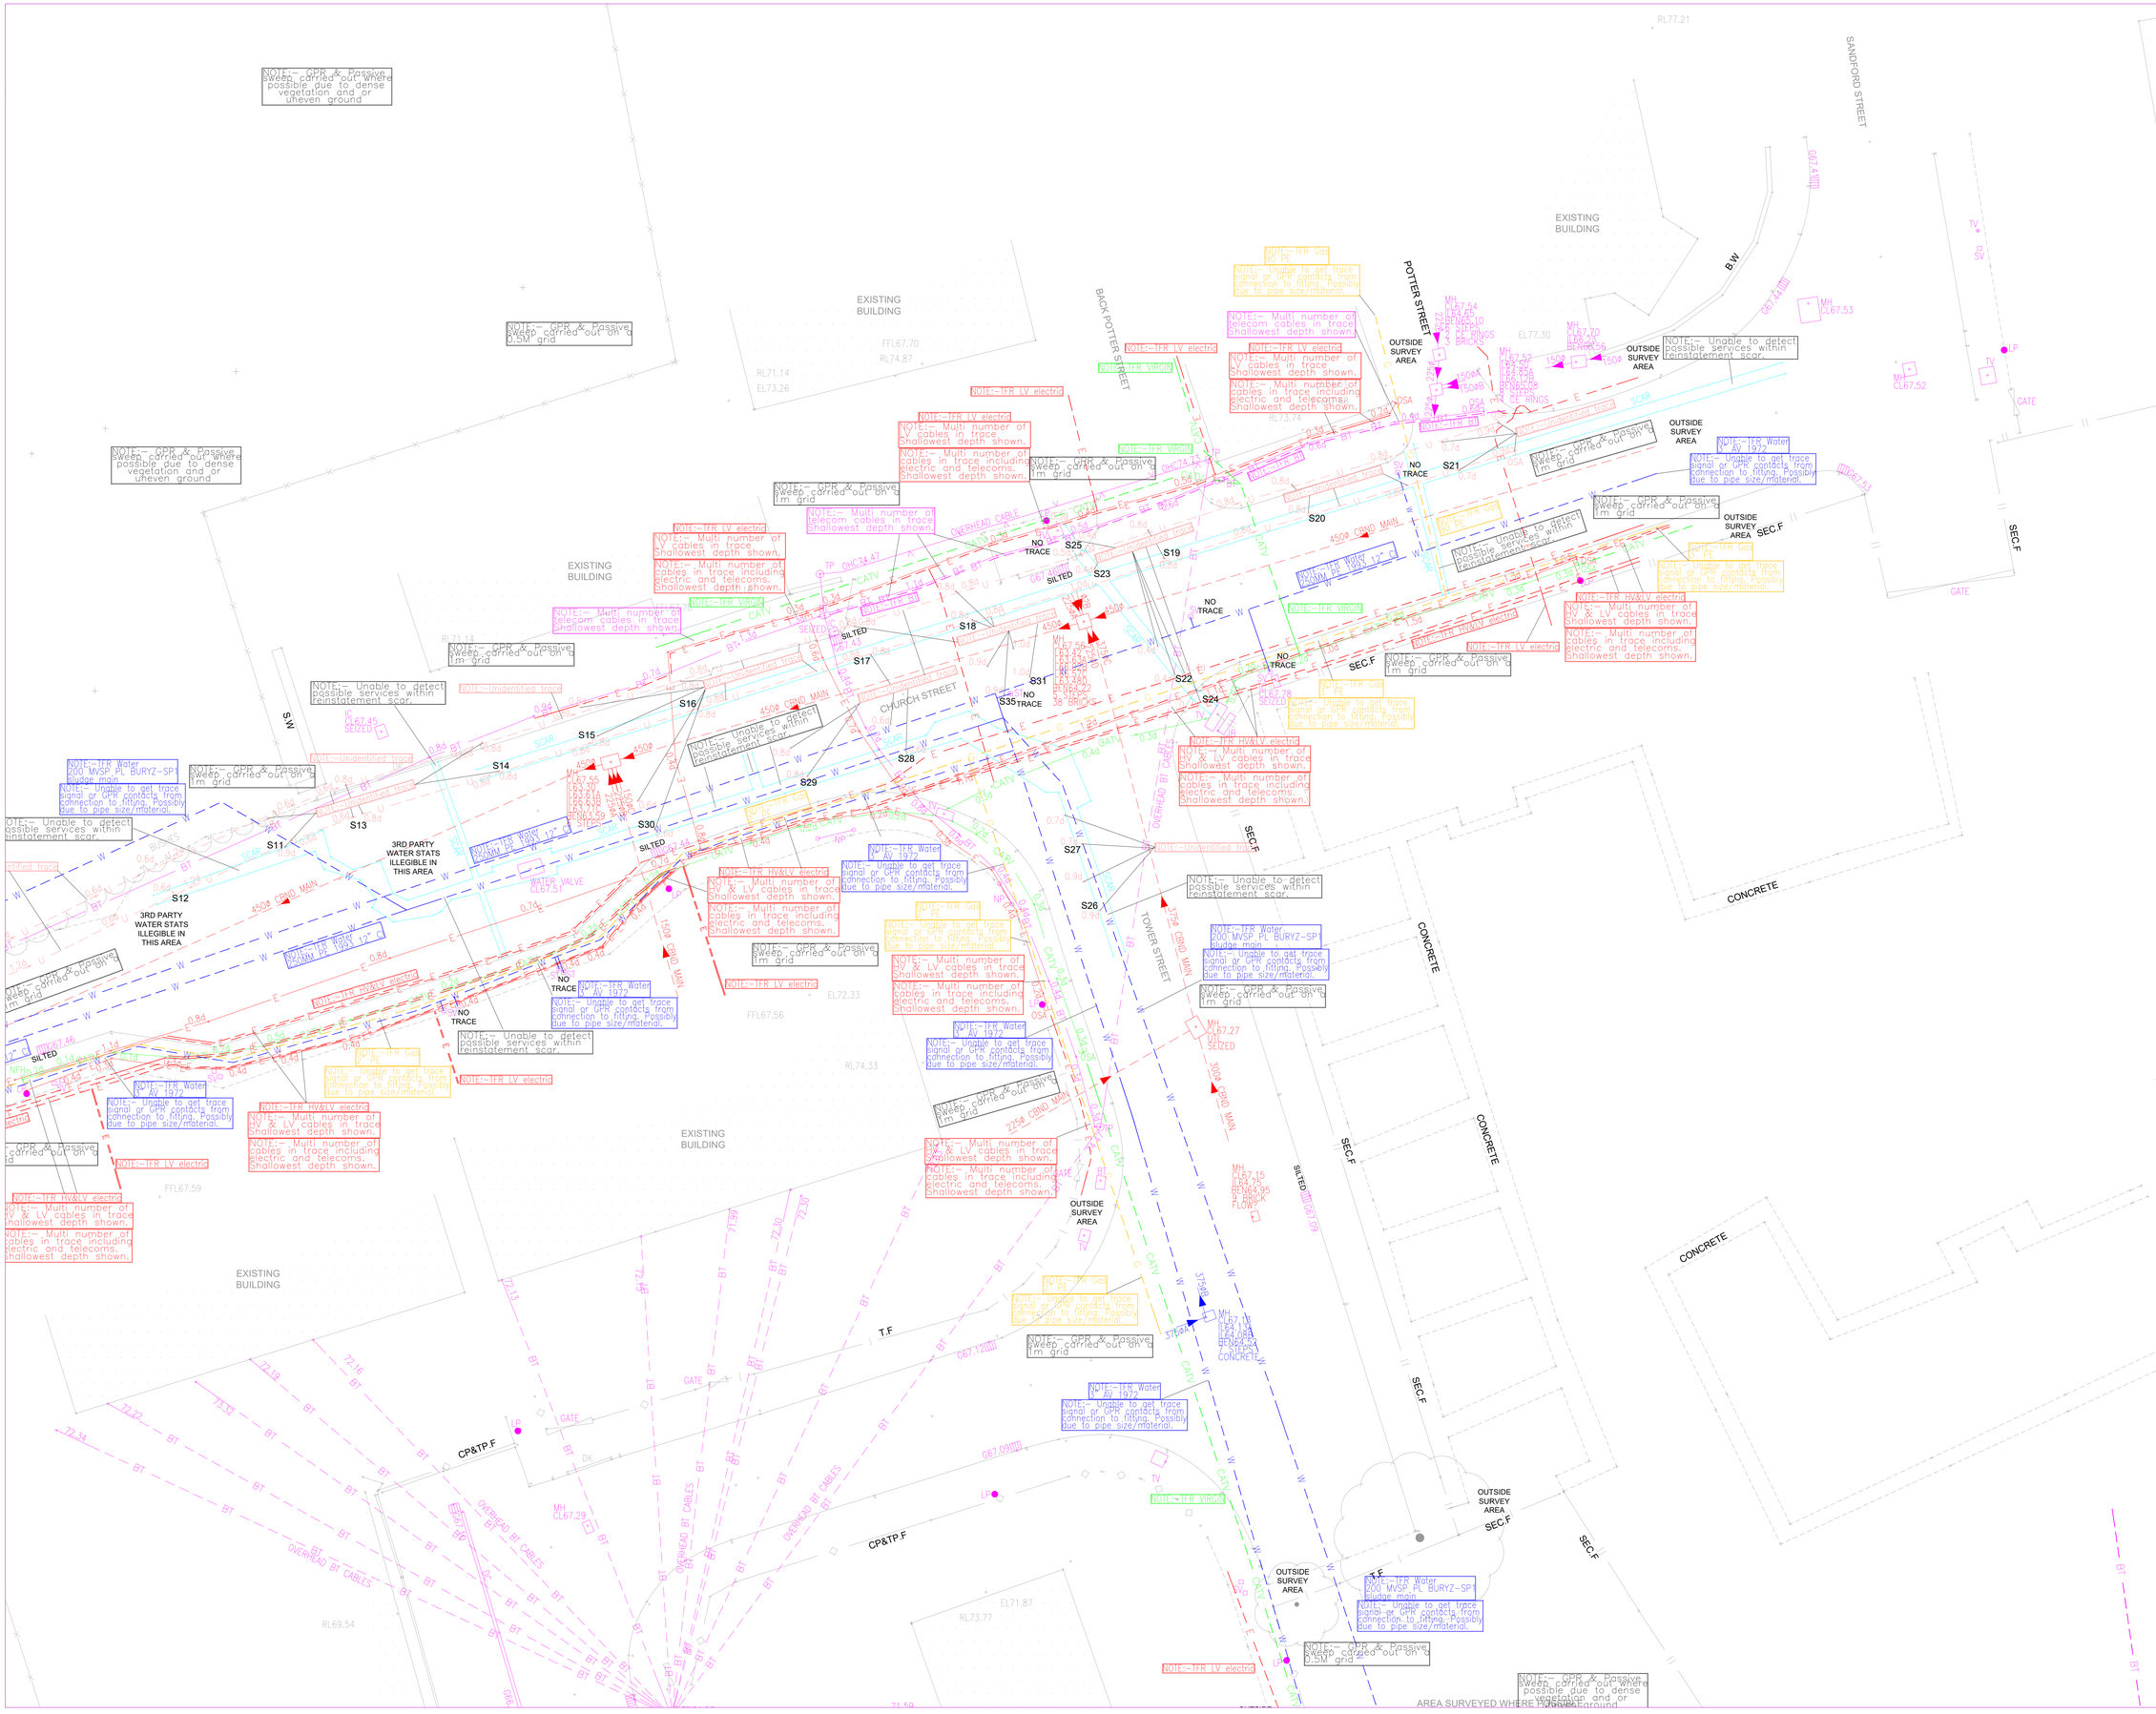

SURVEY ORIENTATED TO OS GRID (OSGB36-15)

SURVEY LEGEND

UTILITY ABBREVIATIONS


UTILITY LEGEND

CABLE TELEVISION	CATV
ELECTRIC	E
ELECTRIC CABLE	E
FIBRE OPTIC CABLE	FO
FOUL WATER SEWER	F
FUEL PIPE	F
GAS PIPE	G
GPR	GPR
HEATING PIPE	H
OVERHEAD TELECOM	BT
OIL PIPE	O
REINSTATEMENT SCAR	R
STORM WATER SEWER	S
TELECOMMUNICATIONS	BT
TRAFFIC SIGNAL CABLE	TS
UNIDENTIFIED CABLE	UC
UNIDENTIFIED PIPE	UP
UNIDENTIFIED TRACE	U
WATER PIPE	W
CABLE DUCT	DUCT
VODAPHONE	V

TAKEN FROM STATUTORY AUTHORITY PLANS

CATV	
ELECTRIC	
SEWER	
SEWER FW	
SEWER WATER SEWER	
STORM GAS	
TELECOMMUNICATIONS	
WATER PIPE	

SURVEY ANNOTATIONS

AV	AIR VALVE
B	BOLLARD
BS	BUS STOP
BT	BRITISH TELECOM IC
CPS	CONCRETE PAVING SLABS
CP	CATCH PIT
DR	DRAIN
EB	ELECTRIC CONTROL BOX
EL	ELECTRICAL IC
EP	ELECTRICITY POLE
ER	EARTH ROD
FH	FIRE HYDRANT
FP	FLAG POLE
G	GULLY
GH	GREENHOUSE
GP	GATE POST
GV	GAS VALVE
IC	INSPECTION COVER
JB	JUNCTION BOX
JKW	JAPANESE KNOT WEED
KO	KERB OUTLET
LH	LAMP HOLE
LP	LAMP POST/LIGHT COLUMN
MH	MANHOLE
MP	MONITOR POINT
NP	NAME PLATE
OHC	OVERHEAD CABLES
PB	POST BOX
PM	PARKING METER
PO	POST
PYL	ELECTRICITY PYLON
RE	RODDING-EYE
RS	ROAD SIGN
RWP	RAIN WATER PIPE
ST	STOP TAP
SM	SERVICE MARKER
SP	SIGN POST
SV	STOP VALVE / SLUICE VALVE
SVP	SOIL VENT PIPE
TB	TELEPHONE BOX
TL	TRAFFIC LIGHTS
TP	TELEGRAPH POLE
TP	TELEGRAPH POLE
TPS	TACTILE PAVING SLABS
VP	VENT PIPE
WM	WATER METER
WO	WASH OUT
U/L	UNABLE TO LIFT
U/S	UNABLE TO SURVEY

STATUTORY RECORDS PROVIDED

TYPE	COMMENTS	TYPE	COMMENTS
SEWERS	YES	CABLE TV	YES
WATER MAINS	YES	ELECTRICITY	YES
GAS MAIN	YES	OIL PIPELINES	NO
BT	YES	OTHER	YES

UNDERGROUND UTILITIES SERVICES DISCLAIMER

We have endeavoured to locate existing utilities using records provided as a guide. In the instance of blocked sewers or untraceable utilities details may have been taken from Utility Record Drawings, which can occasionally be of poor quality. Consequently we cannot guarantee accuracy of information taken from such records. These are shown on the drawing as a dashed line.

Unless indicated, no allowance has been made for sub-surface entry into manholes, other chambers or confined spaces below ground level. Therefore any details relating to depths, sizes etc, are taken from the surface and as such will be approximate.

We have endeavoured to supply you with the most accurate data possible by using methods and equipment that are at the forefront of our industry. We have taken great care in the detection of pipework and buried features, but as with all methods of detecting underground or buried utilities the information provided is based on results obtained from electromagnetic techniques, and as such may be liable to distortion or errors beyond the reasonable control of the operator or his instruments.

It should be noted that certain types of services, such as plastic or concrete pipes or conduits where there is no direct access to the pipe are not traceable by conventional electrodetection methods; for the location of these services, either records drawings should be sought or an alternative means of obtaining the information used.

Depths of services should always be checked by way of trail holes where possible, depths are only approximate as ground conditions / saturation levels can affect the readings we receive from the instrumentation.

It is the responsibility of the user under Health & Safety Guidelines (HSG47) to confirm the accuracy of information provided prior to any excavation of the services shown.

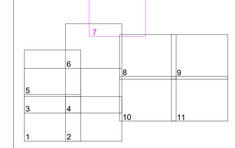

© SurveyEng Limited 2023
Reproduction in whole or in part by any means is prohibited without the prior permission of SurveyEng Limited.

DESCRIPTION	REV	DATE	DRWN	APPR
MANHOLE SURVEY ADDED	C	01.02.23	DH	-
SPRAYED LINE OF CULVERT ADDED	B	04.10.22	BM	-
UTILITY SURVEY UPDATED	A	22.09.22	BM	-

SurveyEng Ltd
Land Surveyors & Engineers
14 GREEN MILL
WESTHOUGHTON
BOLTON
LANCS
BL5 3GE
TEL/FAX: 0800 772 3040
MOB: 07850080993
info@surveyeng.co.uk

CLIENT
MORRIS HOMES

PROJECT TITLE
EAST LANCS PAPER MILL, RADCLIFFE

DRAWING DETAIL
UTILITY SURVEY
SHEET 7 OF 17

PROJECT ENGINEER	CT	DATE	03.08.2022
DRAWN	BM	SCALE	1:100@A0

DRAWING NUMBER	REVISION
MH.US.44	C